



FLOORPLAN

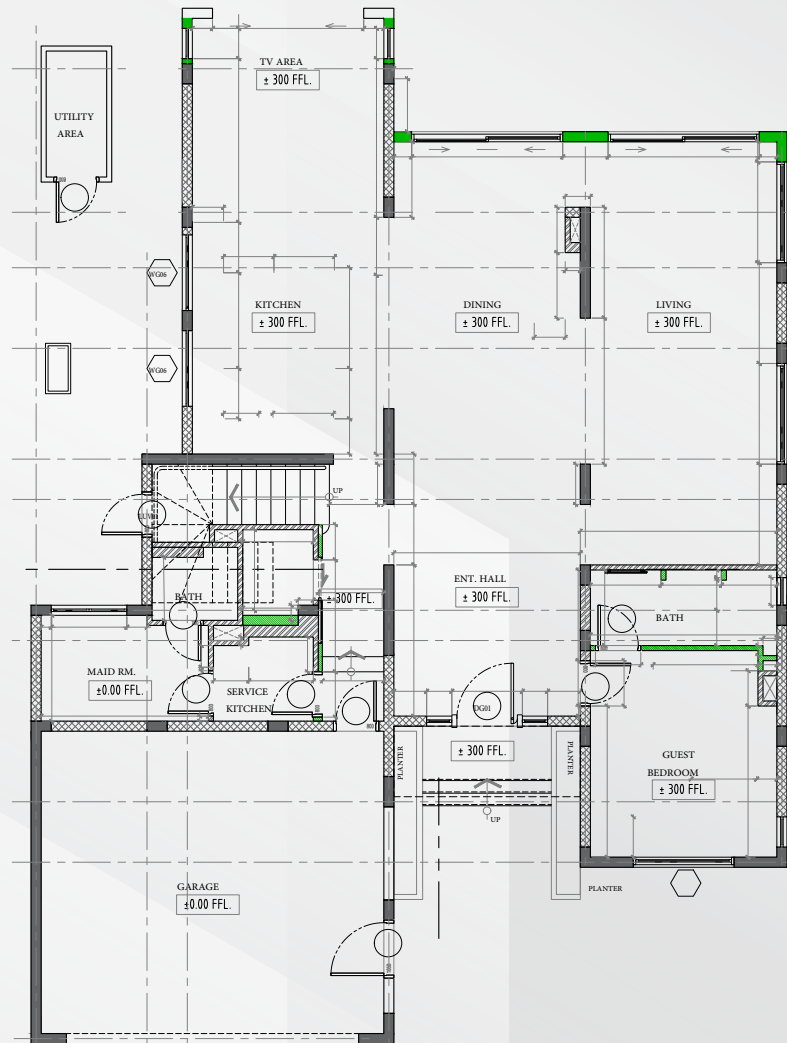

01
 VILLA 19, MEADOWS 3 - RENOVATION
AS BUILT - GROUND FLOOR PLAN
 AR-01 SCALE 1:150 mm

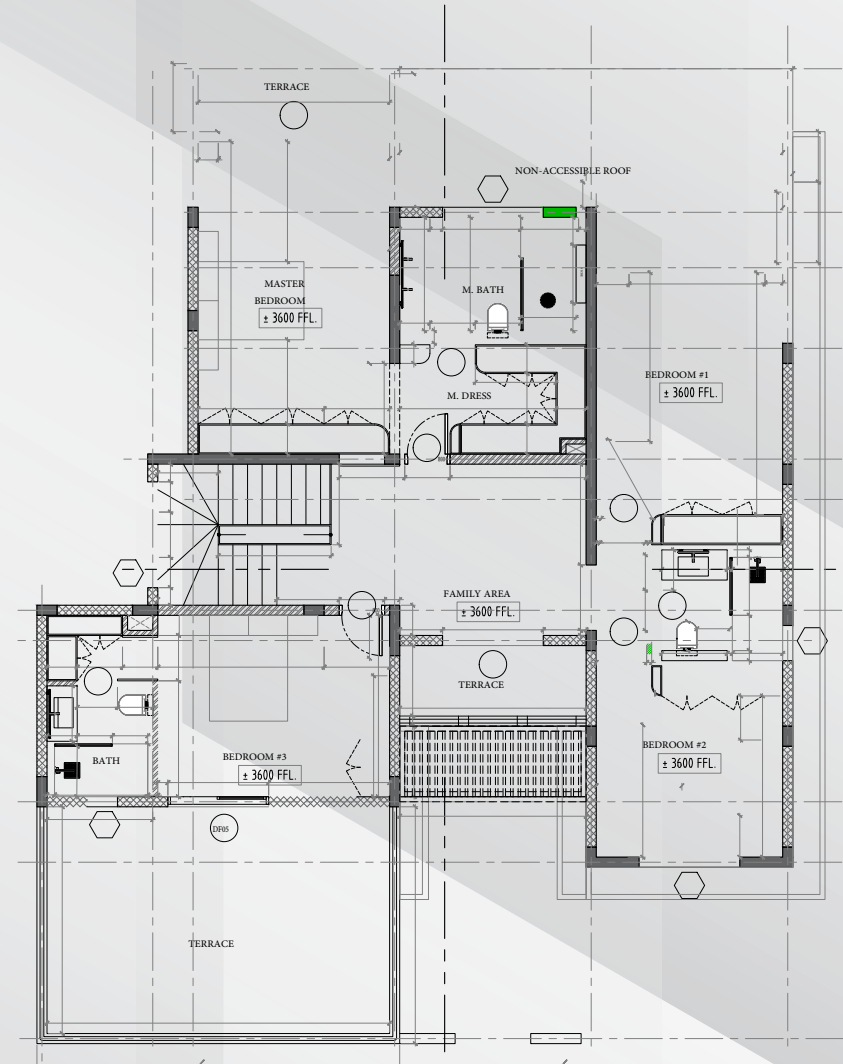

02
 VILLA 19, MEADOWS 3 - RENOVATION
AS BUILT - FIRST FLOOR PLAN
 AR-01 SCALE 1:150 mm