

LANDSCAPE VIEWS

MEADOWS 3 V19

MEADOWS 3

5 BR VILLA
BUA 3,158 SQFT



LANDSCAPE VIEWS

Located in the sought-after Meadows 3 community, this Type V19 villa offers a spacious and well-balanced family layout with 3,158 sq. ft. of built-up area.

The home features multiple living and dining areas, a functional kitchen, four to five bedrooms including a generous master suite, as well as a maid's room and ample storage. Set on a sizeable plot with a private landscaped garden and covered parking, the villa presents excellent potential for renovation or customization, making it an ideal choice for end-users seeking a quiet, established neighborhood with strong long-term value.



Gymnasium



Jogging Track



Outdoor Dining



Pool




Play Area




Parks

FLOORPLAN

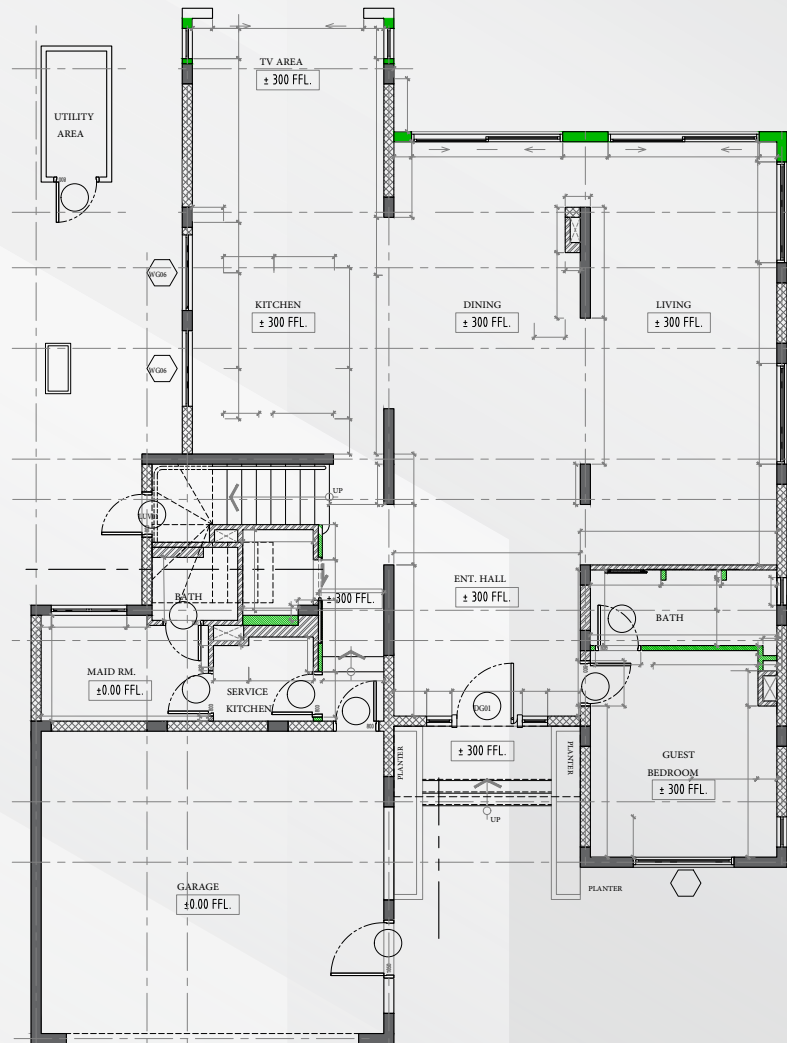

01
 VILLA 19, MEADOWS 3 - RENOVATION
AS BUILT - GROUND FLOOR PLAN
 AR-01 SCALE 1:150 mm

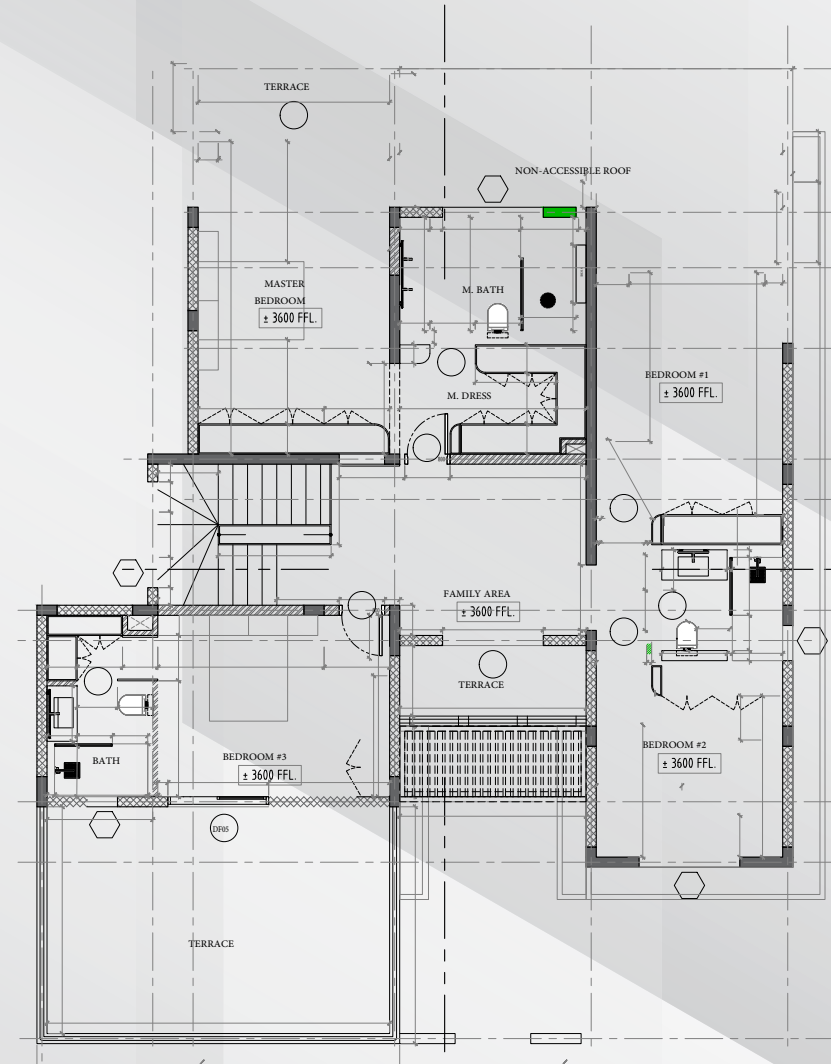

02
 VILLA 19, MEADOWS 3 - RENOVATION
AS BUILT - FIRST FLOOR PLAN
 AR-01 SCALE 1:150 mm

**IN THE
HEART
OF A
VIBRANT
LOCATION**

